

1924 Fourth Street
San Rafael, CA 94901
Fax 415.458.5401
Tel 415.458.5400

STRUCTURAL
ENGINEERING BY:

KENT ENGINEERING, INC.
Robert Kent
3608 Aaron Drive
Santa Rosa, CA 95404
ph: 707-526-7956
fax: 707-526-9138

LOWTHER / ABOWD RESIDENCE
9 Chaparral Lane, San Geronimo
APN 170-182-03

CISTERN
PIPING PLAN
&
SECTIONS



NO.	DATE	REVISIONS			
		REVISIONS PER PLAN CHECK COMMENTS	REVISIONS PER COUNTY PLANNING	REVISIONS PER OWNER	BUILDING PERMIT ISSUANCE
1	9-25-09				
2	9-30-09				
3	9-25-09				
4	10-12-09				

Date Issued

August 21, 2009

A3.2

AS NOTED

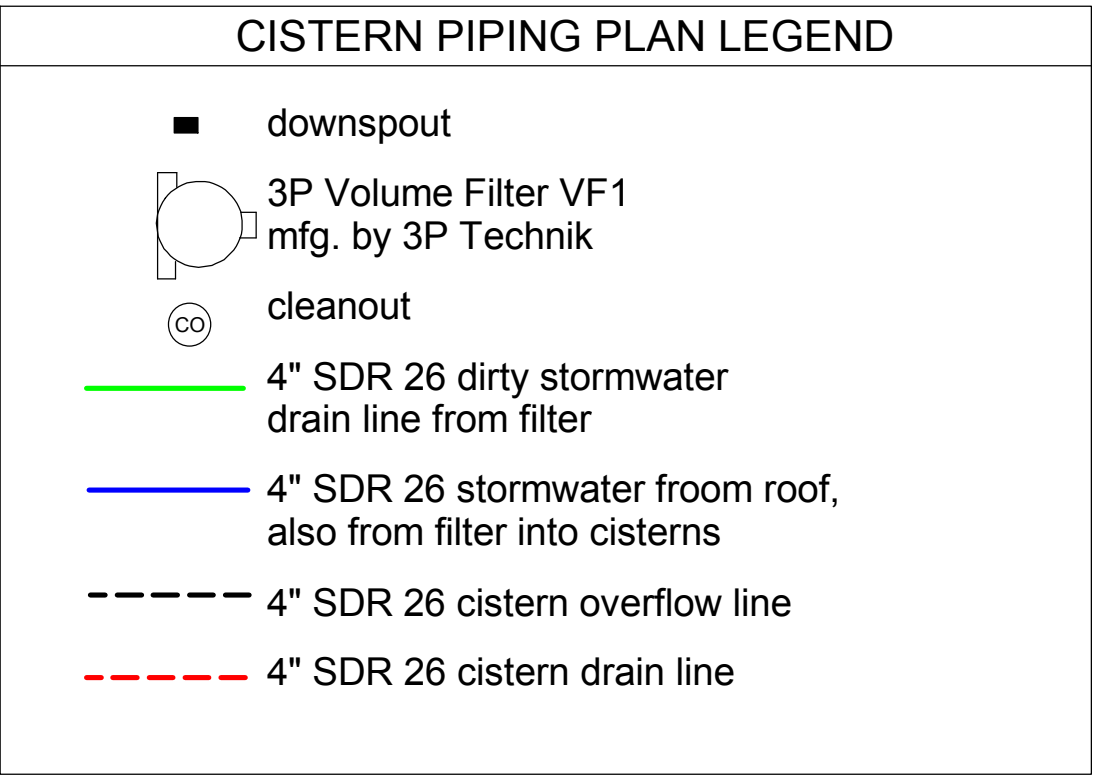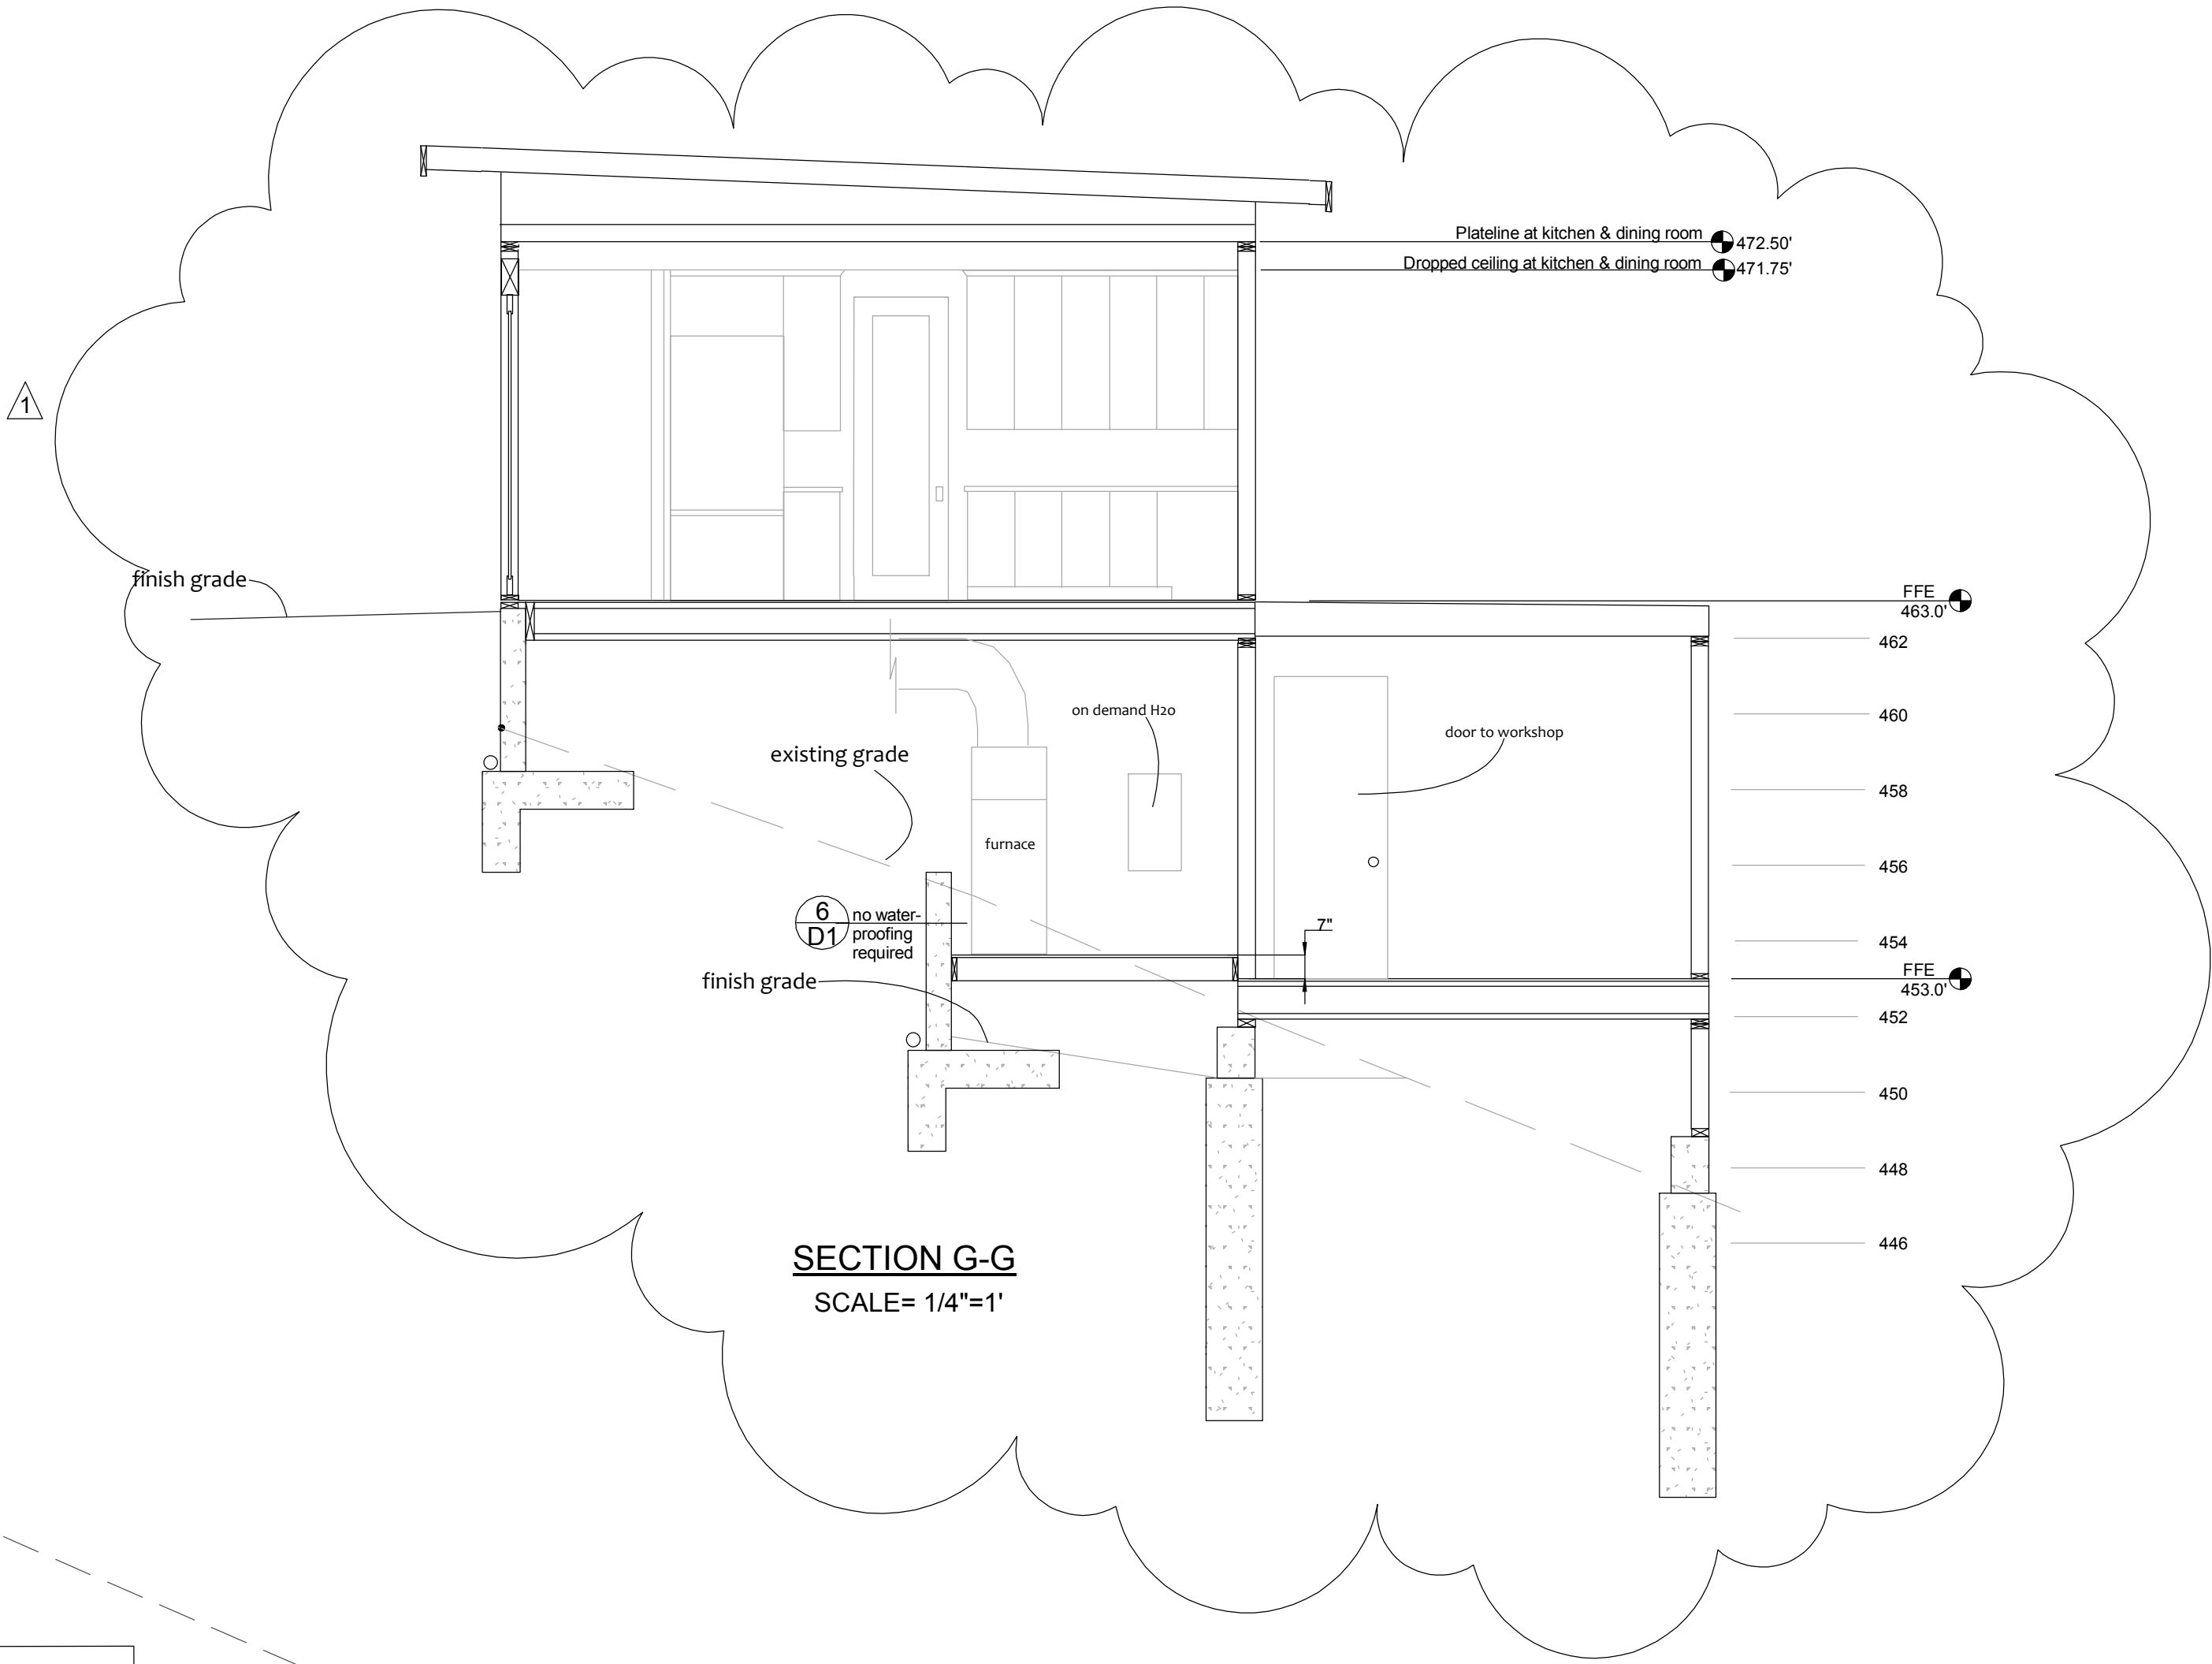

NOTES:

Provide 30" minimum clearance from top of filter to underside of joists for cleaning


Provide wyes or 45 degree fittings at all bends

Cleanouts to have threaded connections

Piping to be hung from joists using plumber's DWV hangers

Piping to be installed with slope no greater than 1/4" per foot

Provide cleanout wyes at bottom of downspout on building exterior

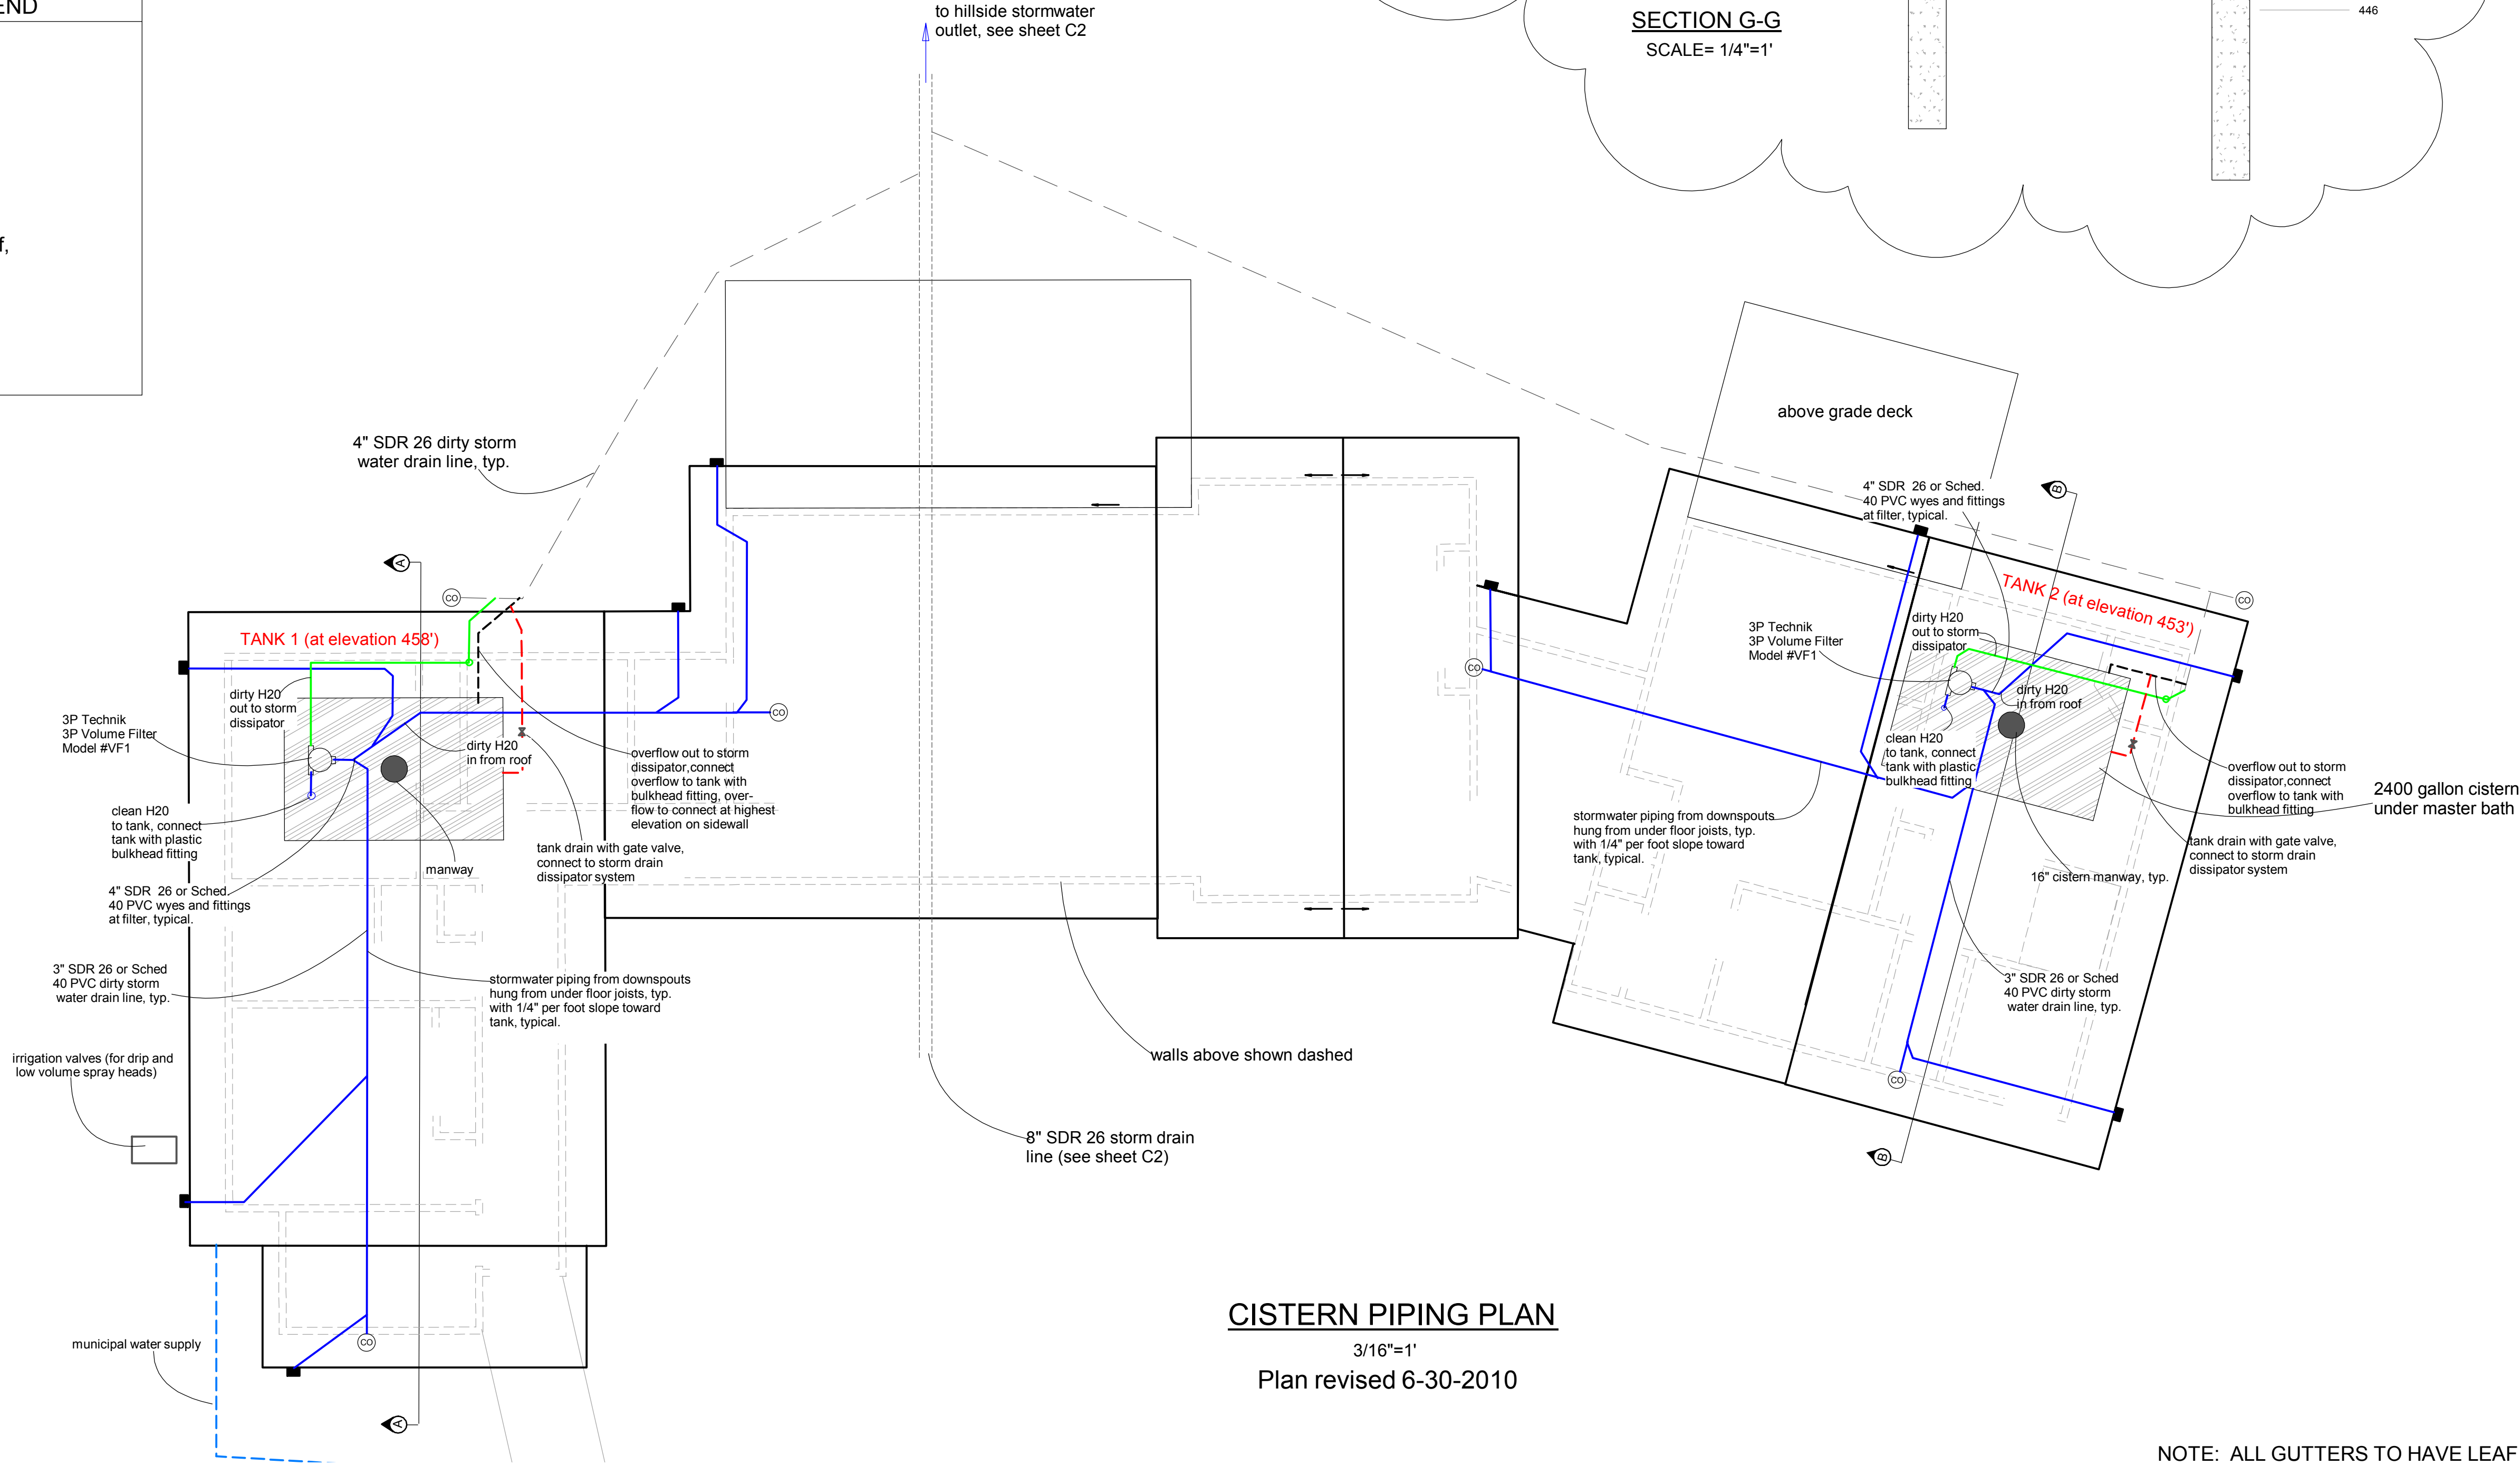

CISTERN PIPING PLAN
3/16"=1'
Plan revised 6-30-2010

NOTE: ALL GUTTERS TO HAVE LEAF GUARDS